


1 FIRST FLOOR PLAN

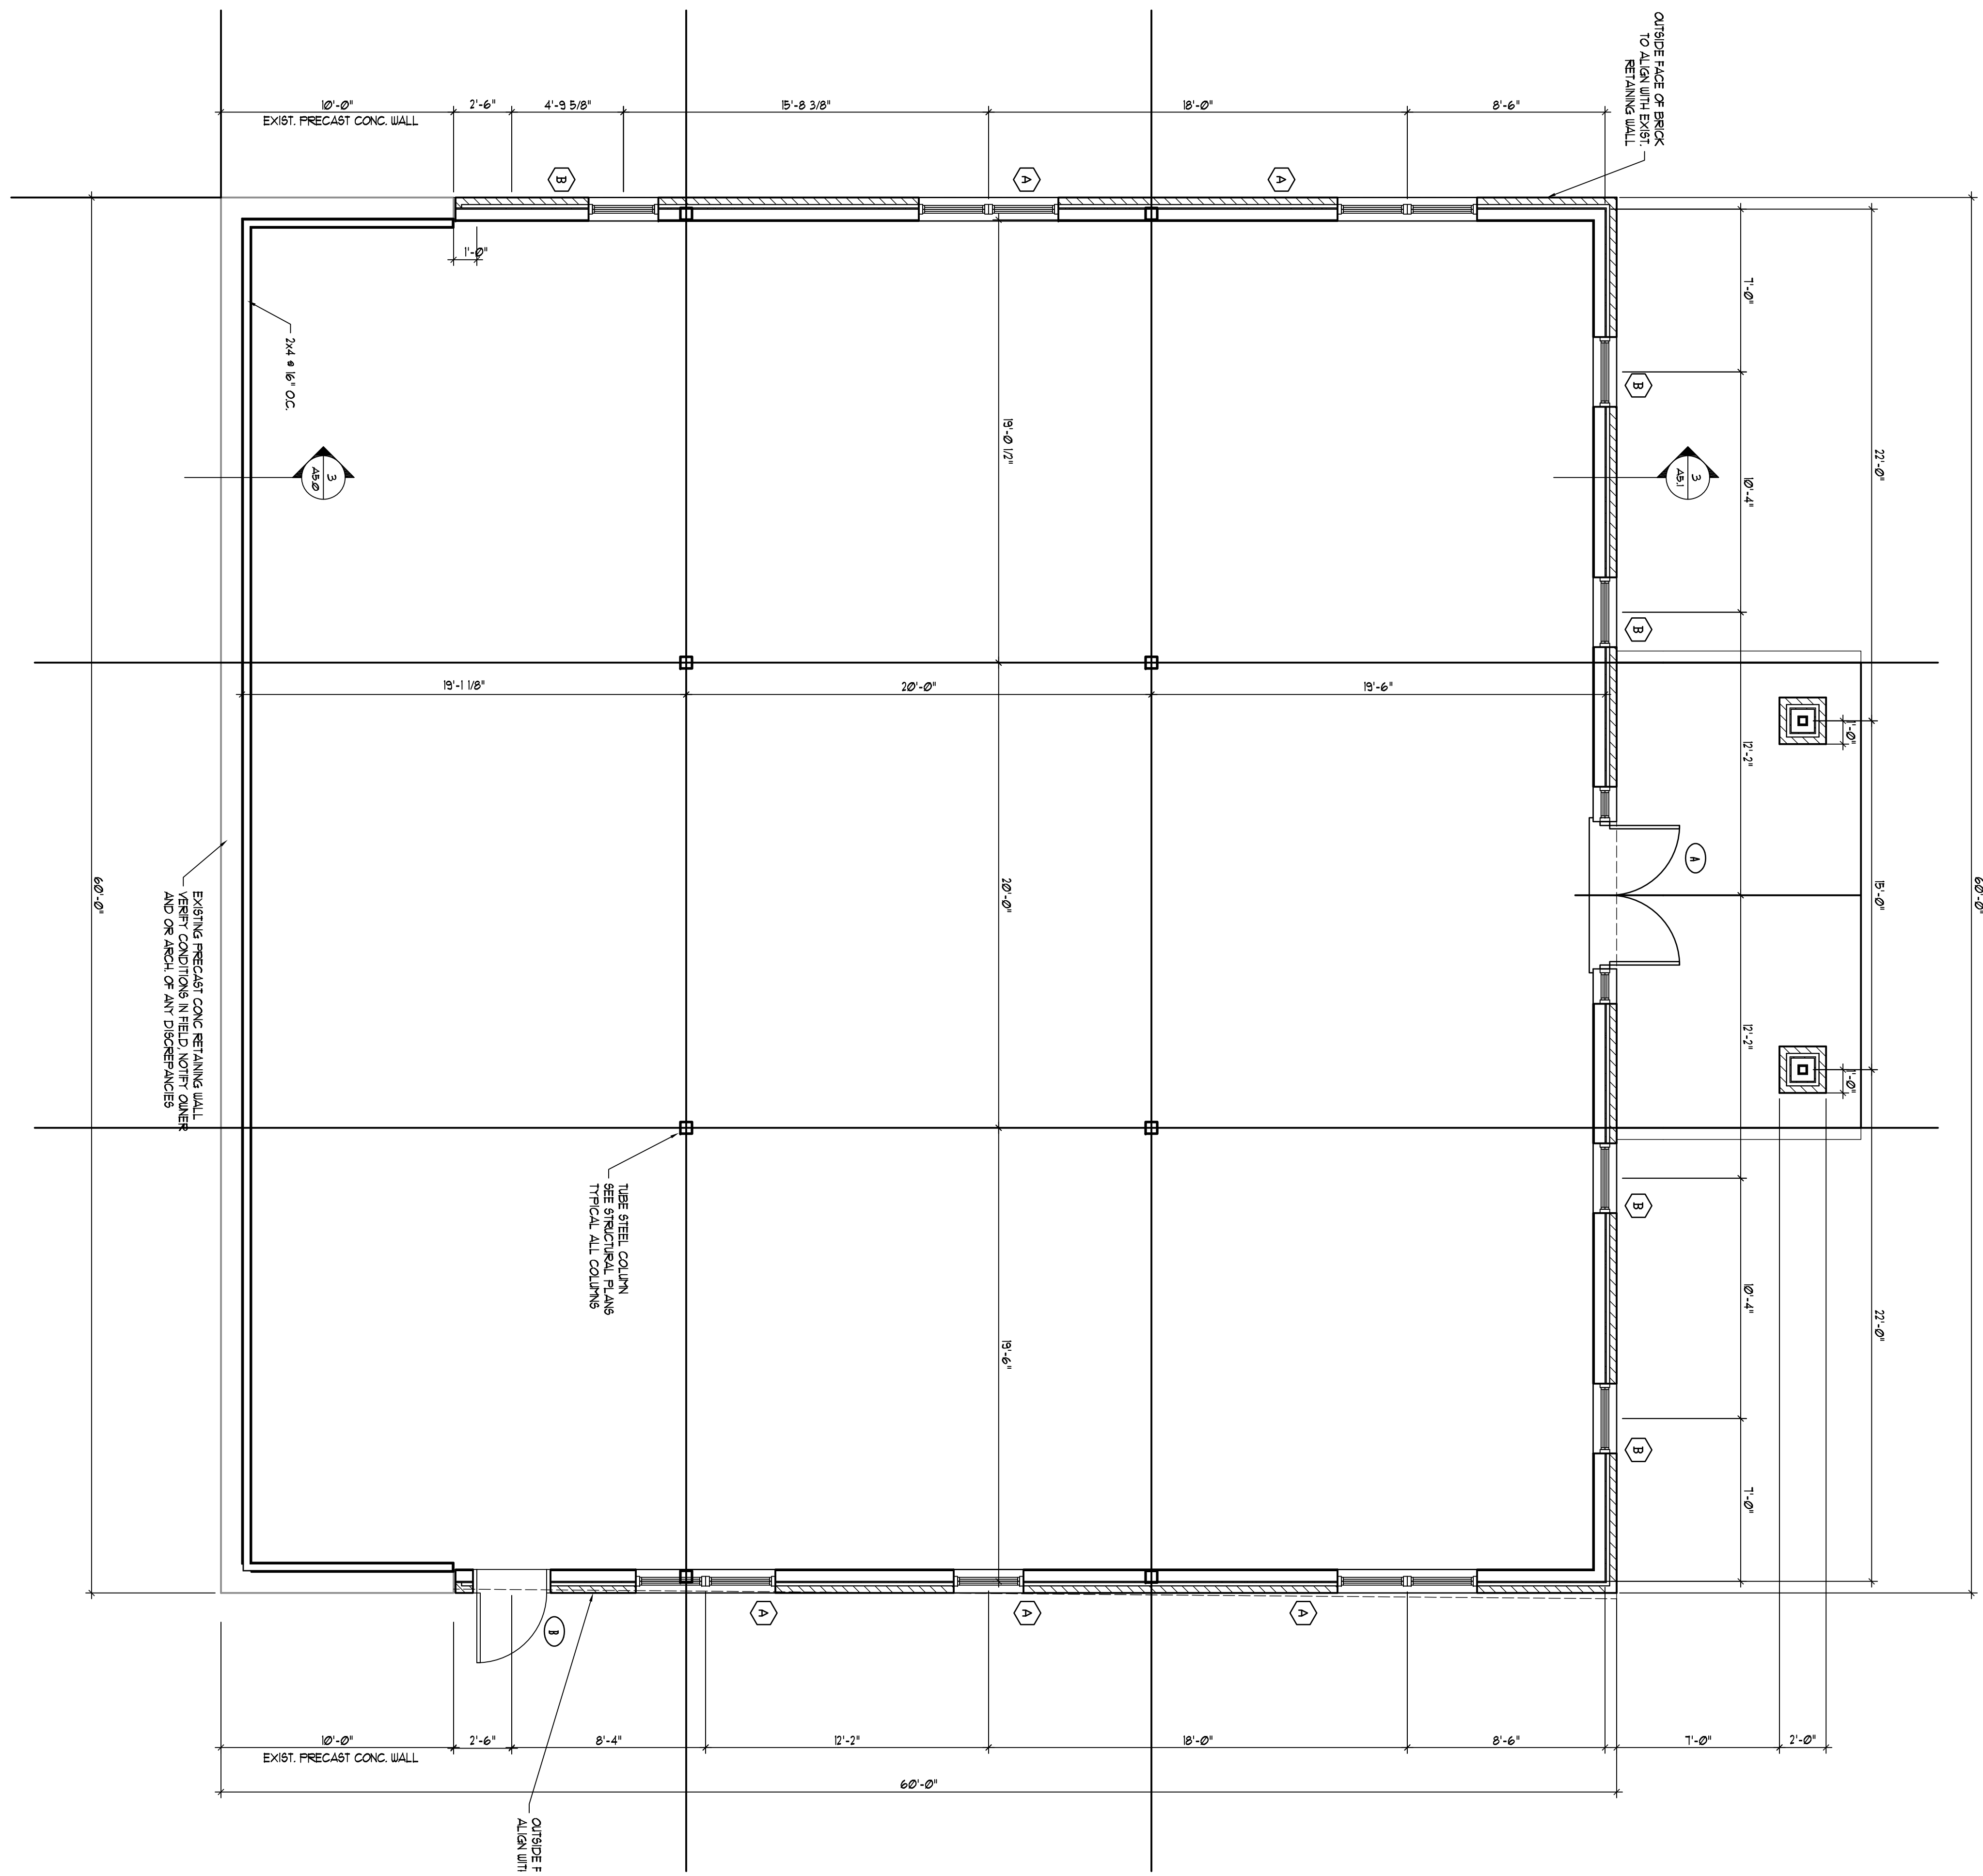

SCALE: 1/4" = 1'-0"


2 DOOR & WINDOW TYPES

SCALE: 1/4" = 1'-0"

JANNEY GREER  
701 ROPER CREEK DR.  
GREENVILLE, SOUTH CAROLINA 29615  
**FIRST FLOOR PLAN**

**LANGLEY & ASSOCIATES**  
ARCHITECTS, LLC

109 SOUTH MAIN STREET  
GREER, SOUTH CAROLINA 29650  
PHONE: (864) 988 - 0224  
FAX: (864) 988 - 9550  
[www.la-architects.com](http://www.la-architects.com)

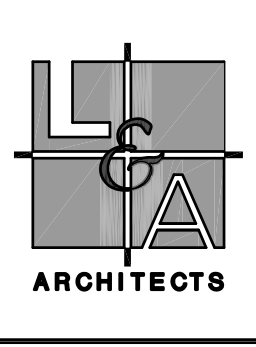

REVISIONS		
NO.	DATE	DESCRIPTION

**A2.0**