



FIRST FLOOR PLAN
 A1
 A1.01 3/16" = 1'-0"

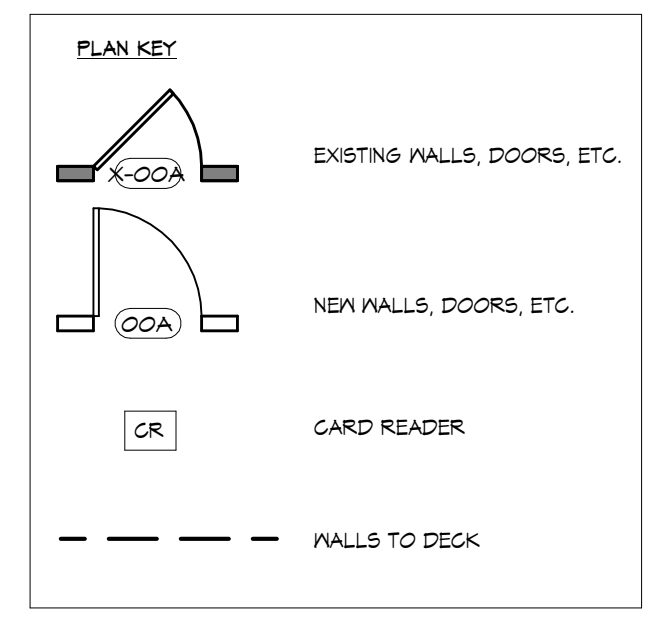

FLOOR PLAN NOTES:

1. PROVIDE PAINTED WOOD SILLS AT EXISTING WINDOWS. SEE A4.11. VERIFY DIMENSIONS IN FIELD.
2. PROVIDE MINI-BLINDS AT ALL EXISTING WINDOWS, FULL HEIGHT. VERIFY SIZE IN FIELD.

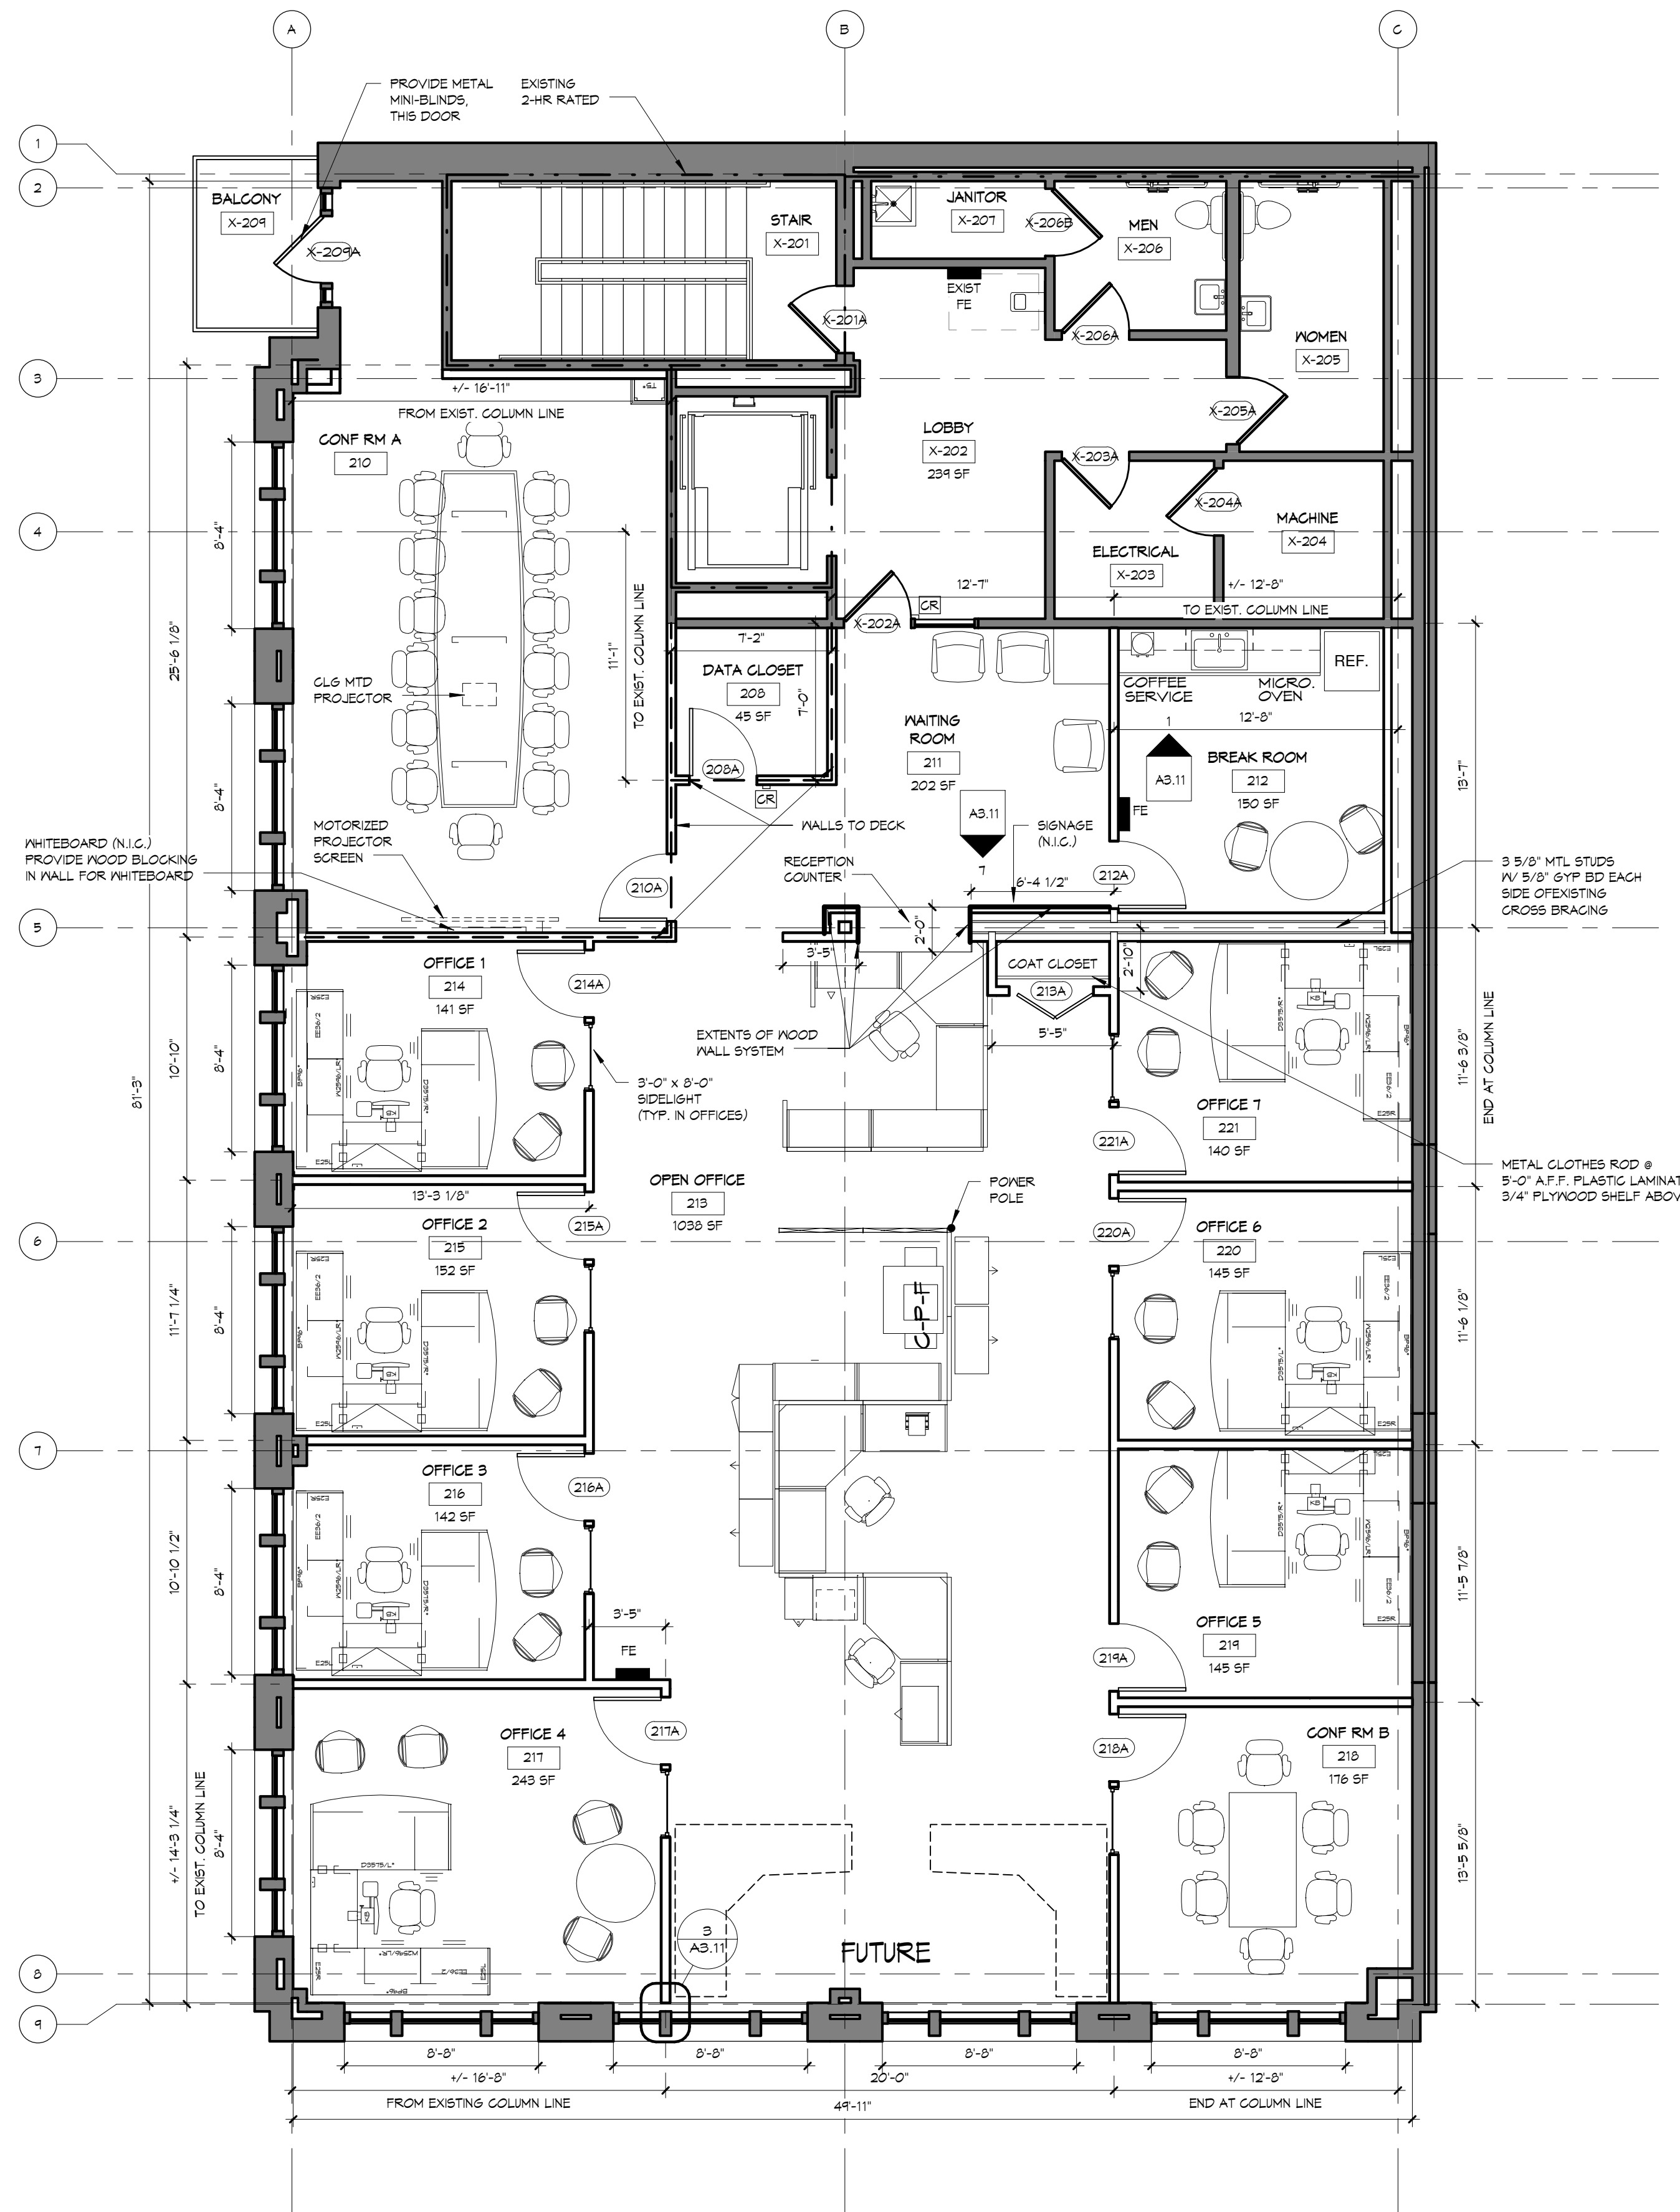

SECOND FLOOR PLAN
 1
 A1.01 3/16" = 1'-0"

ALL DRAWINGS, SPECIFICATIONS, AND CONDITIONS ARE SUBJECT TO THE USUAL AND USUAL SUPPLEMENTARY CONDITIONS OF CONTRACT FOR ARCHITECTURAL SERVICES. THE ARCHITECT ASSUMES NO LIABILITY FOR THE ACCURACY OF THE INFORMATION PROVIDED TO THE ARCHITECT. THE ARCHITECT MAKES NO REPRESENTATIONS AS TO THE ACCURACY OR COMPLETENESS OF SUCH INFORMATION.



mc millan | pazdan | smith
 architecture
 charleston
 greenville
 spartanburg
 2120 nolette blvd ste 100 charleston, sc 29405 o. 843.566.0771 f. 843.566.0775
 www.mcmillanpazdansmith.com

FIFTH THIRD BANK UPFIT

33 S. Main Street

Greenville, SC



SHEET ISSUE:

NO.	DATE	DESCRIPTION	BY
A	12-16-11	PERMIT - PRICING SET	

THE ORIGINAL DOCUMENTS, PREPARED BY MCMILLAN PAZDAN SMITH ARCHITECTURE HAVE BEEN MODIFIED TO INCORPORATE FIELD CHANGES MADE BY THE CONTRACTOR(S) BASED ON MARKED-UP PRINTS PROVIDED BY THE CONTRACTOR AND OTHER DATA ASSOCIATED WITH CHANGES IN THE WORK AUTHORIZED BY THE OWNER. THE ARCHITECT REPRESENTS THAT THESE RECORD DOCUMENTS HAVE BEEN PREPARED ON THE BASIS OF INFORMATION PROVIDED TO THE ARCHITECT BUT MAKES NO REPRESENTATIONS AS TO THE ACCURACY OR COMPLETENESS OF SUCH INFORMATION.

PRINCIPAL IN CHARGE: JNP
 PROJECT ARCHITECT: HBA
 DRAWN BY: KAJ

SHEET TITLE:
FIRST + SECOND FLOOR PLAN

SHEET NO. PROJ. NO.
 11268

A1.01